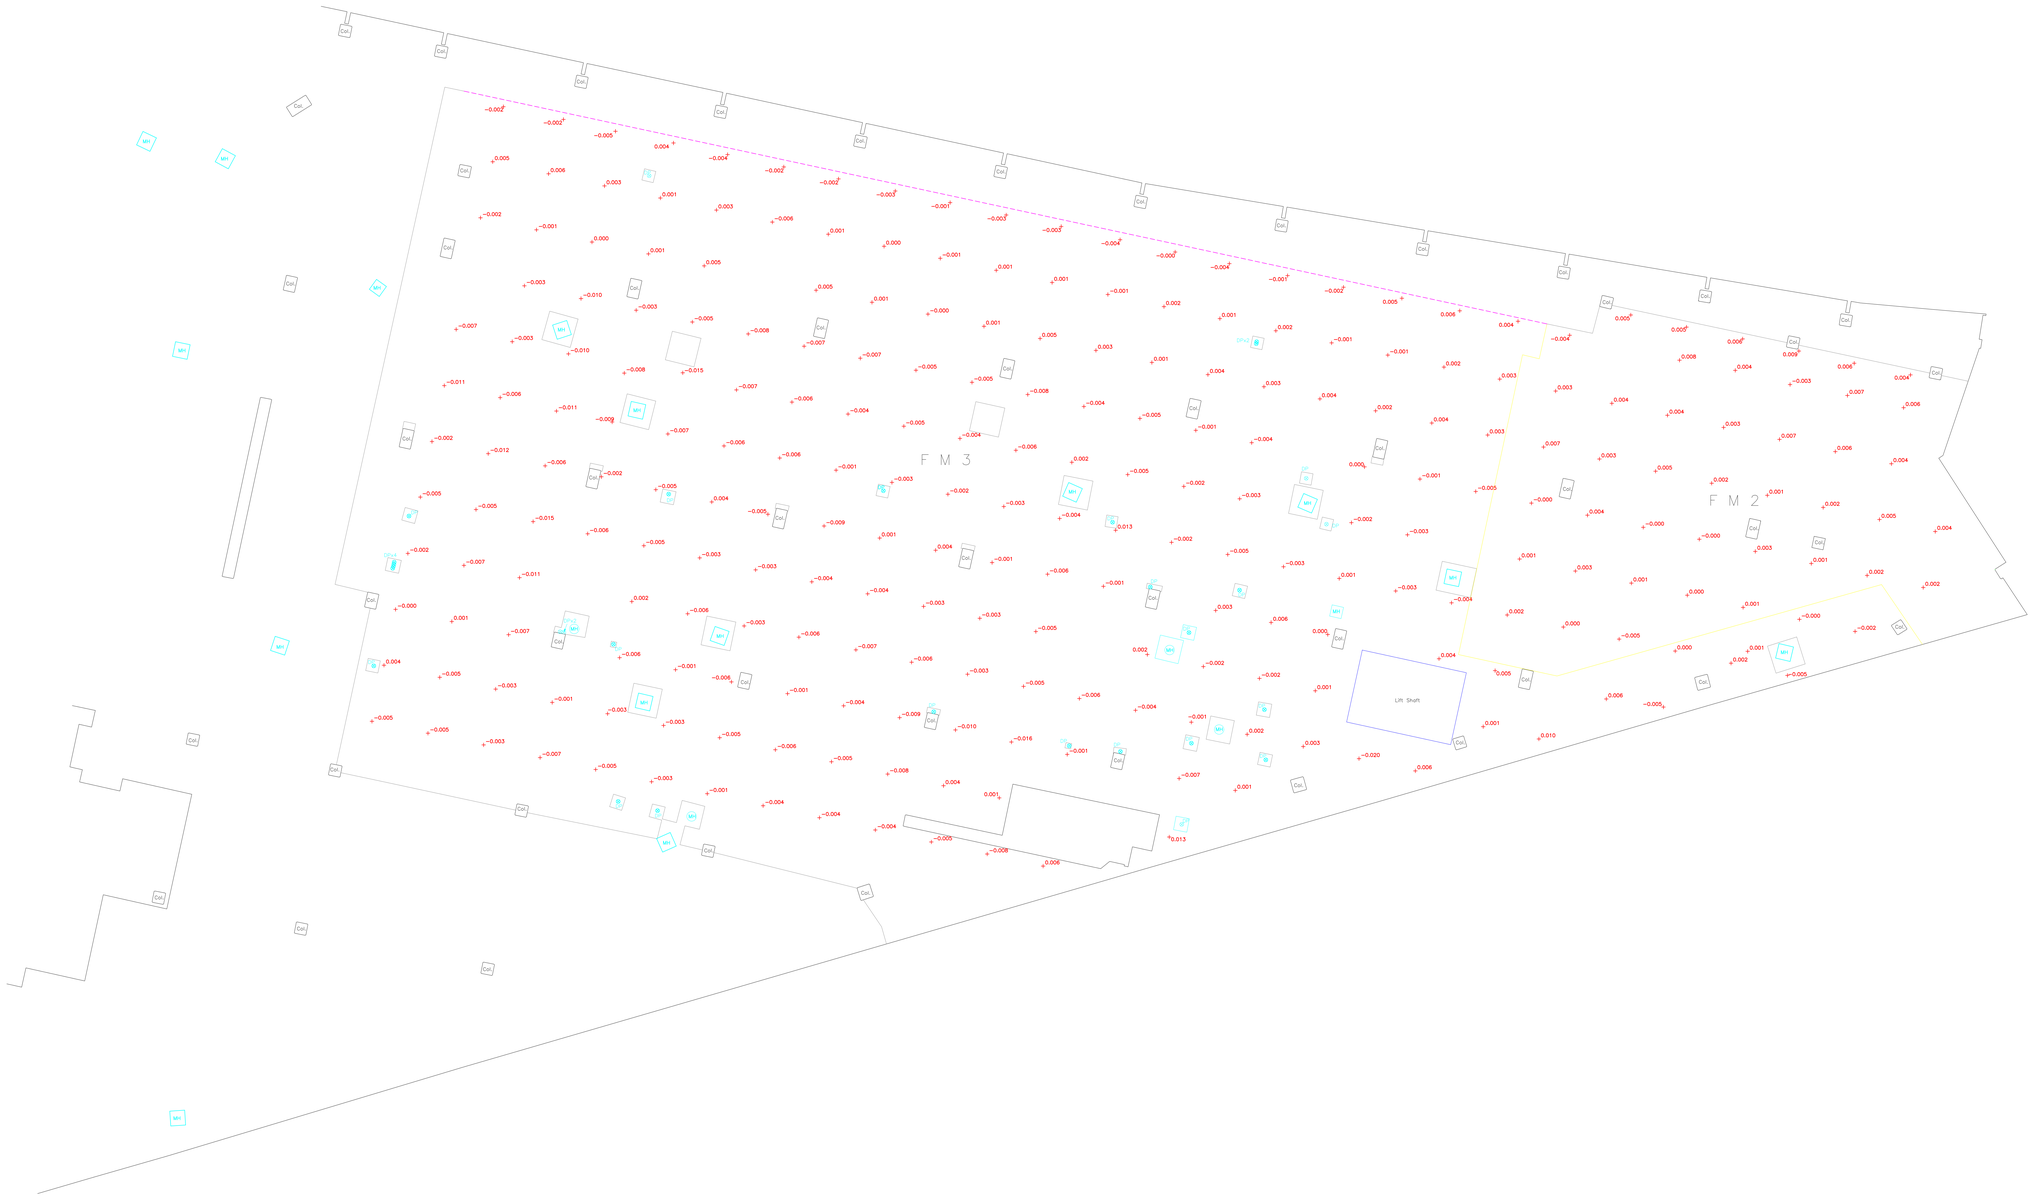


## STANDARD ABBREVIATIONS

| | | | |
|---|---|---|---|
| A/C | AIR CON UNIT | LP | LAMP POST |
| AV | AIR VALVE | MH | MAN HOLE |
| BO | BOLLARD | O/H | OVERHEAD |
| BR | BUILDING BEACON | PO | POST |
| BW | BRICK WALL | PB | POST BOX |
| BS | BUS STOP | PL | PAVEMENT LIGHT |
| BWF | BARBED WIRE FENCE | P&R | POST & RAIL FENCE |
| C.A.T.V | CABLE TV IC | P&W | POST & WIRE FENCE |
| CB | CRASH BARRIER | (R) | FROM RECORDS |
| CBF | CLOSE BOARD FENCE | RE | ROD/INS EYE |
| CH | CHIMNEY | RG | ROAD GULLY |
| CLF | CHAIN LINK FENCE | RS | ROAD SIGN |
| COL | COLUMN | R.T.W | RETAINING WALL |
| CP | COPING LEVEL | SAP | SAPLING |
| CPF | CONC PANEL FENCE | SB | SIGN BOARD |
| (dilap) | DILAPIDATED | SoF | SOFFIT LEVEL |
| (dis) | DISUSED | SP | SIGN POST |
| EP | ELEC SERVICE PIPE | SV | STOP TAP |
| EL | EAVES LEVEL | ST | STAY |
| EIC | ELECTRIC IC | SV | STOP VALVE |
| EP | ELECTRICITY POLE | TCB | TELEPHONE CALL BOX |
| ER | EARTHING ROD | TIC | TELECOMS IC |
| FH | FIRE HYDRANT | TL | TRAFFIC LIGHT |
| FP | FLAG POLE | TP | TELEGRAPH POLE |
| GI | GRATE | TR | TRIP RAIL |
| GV | GAS VALVE | TT | THRESHOLD LEVEL |
| HT | HEIGHT | (U) | UNIDENTIFIED |
| IC | INSPECTION COVER | (U/S) | UNABLE TO LIFT |
| IL | INVERT LEVEL | VP | VENT PIPE |
| IRF | IRON RAILING FENCE | WM | WATER METER |
| JB | JUNCTION BOX | WV | WATER VALVE |
| LB | LETTER BOX | | |

Diameter (trunk)
TREE Height
Spread (radius)

GATE
SLOPE SYMBOL (Bottom—Top)
STN 1 SURVEY STATION
26.34 SPOT LEVEL
2.20 CLEARANCE HEIGHT & TAG

## SERVICE TRACING LEGEND AND NOTES

DRAINAGE & Flow Direction
WATER
GAS
Caution: Tracing of uPVC Gas Pipes Not possible, Gas Lines May Have Also Been Shown From Utility Records ONLY.
ELECTRICITY
TELECOM
CABLE TV
UNDERGROUND CHAMBER

Note:
All Pipe sizes in millimeters unless stated otherwise

## CAUTIONARY NOTES

ELECTRO-DETECTION TECHNIQUES HAVE BEEN USED TO OBTAIN THE LOCATION OF UNDERGROUND SERVICES. THE RESULTS ARE NOT INFALLIBLE AND TRIAL EXCAVATIONS MUST BE CARRIED OUT TO CONFIRM SERVICE IDENTIFICATION, POSITIONS AND PARTICULARLY DEPTHS. ALTHOUGH ALL REASONABLE EFFORT HAS BEEN MADE IN SEARCHING AVAILABLE RECORD DRAWINGS, THE COMPLETENESS OF THE UNDERGROUND SERVICE INFORMATION CANNOT BE GUARANTEED.

N

Layout Plan

General Notes

Co-ordinate System
This survey is produced on:
An Arbitrary Co-ordinate Grid based upon drawing ADP-00-B1-DR-A-1025

Survey Accuracy
This survey has been carried out to an accuracy consistent with a scale presentation of that listed in title below. Interrogated dimensions will be within the tolerance associated with this and smaller scales only.

Bench Mark Details
Levels are related to:
A Level Datum based upon drawing 23916A_01_FS & the level 132.14 located on the slab level of the Level 1 stairwell.

| Rev. | Date | By | Revision Details |
|---|---|---|---|
| | | | |
| | | | |
| | | | |
| | | | |
| | | | |

Client

Title
Barclaycard Arena

LEVEL 1—SLAB LEVEL CHECK

| | | | |
|---|---|---|---|
| Scale | 1:100 | Date | 15/09/17 |
| File | 2501-L | Checked | LB A0++ |
| Sheet Number | 1 OF 1 | Job No. | 2501 |


SITE TEAM SERVICES
T: 0872 654 0140
E: enquiries@siteteamservices.com
www.siteteamservices.com


| Drawing No. | Rev. |
|---|---|
| 2501—L | |